

AMENDMENTS TO THE DRAWINGS

Please amend Figures 1 and 2 as described below.

In Figure 1, the reference numeral "16" referring to "bank" has been changed to "15".

In Figure 1, a reference numeral "12" and an indicating line therefor have been added to identify a rectangular box, which is referred to as "main computer 12" in the specification.

In Figure 2, an arrowhead contacting a block (128) has been deleted.

A "Replacement Sheet" for each sheet of drawings being amended can be found in the Appendix. Also, for the Examiner's reference, accompanied are the drawings showing the above-described amendments in red.

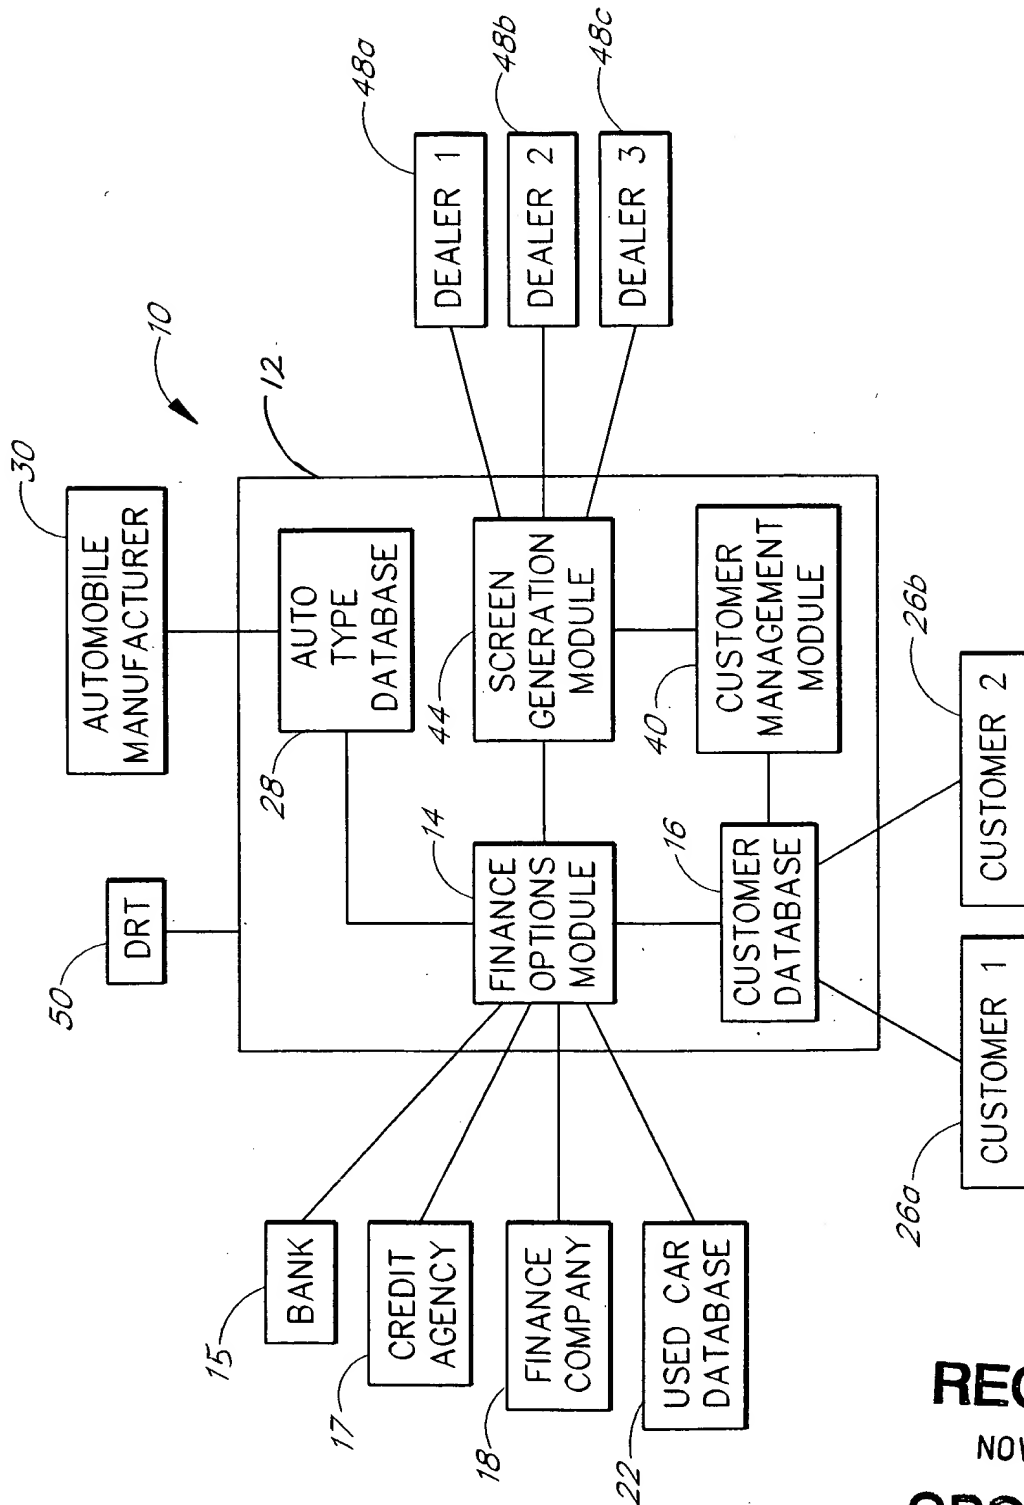
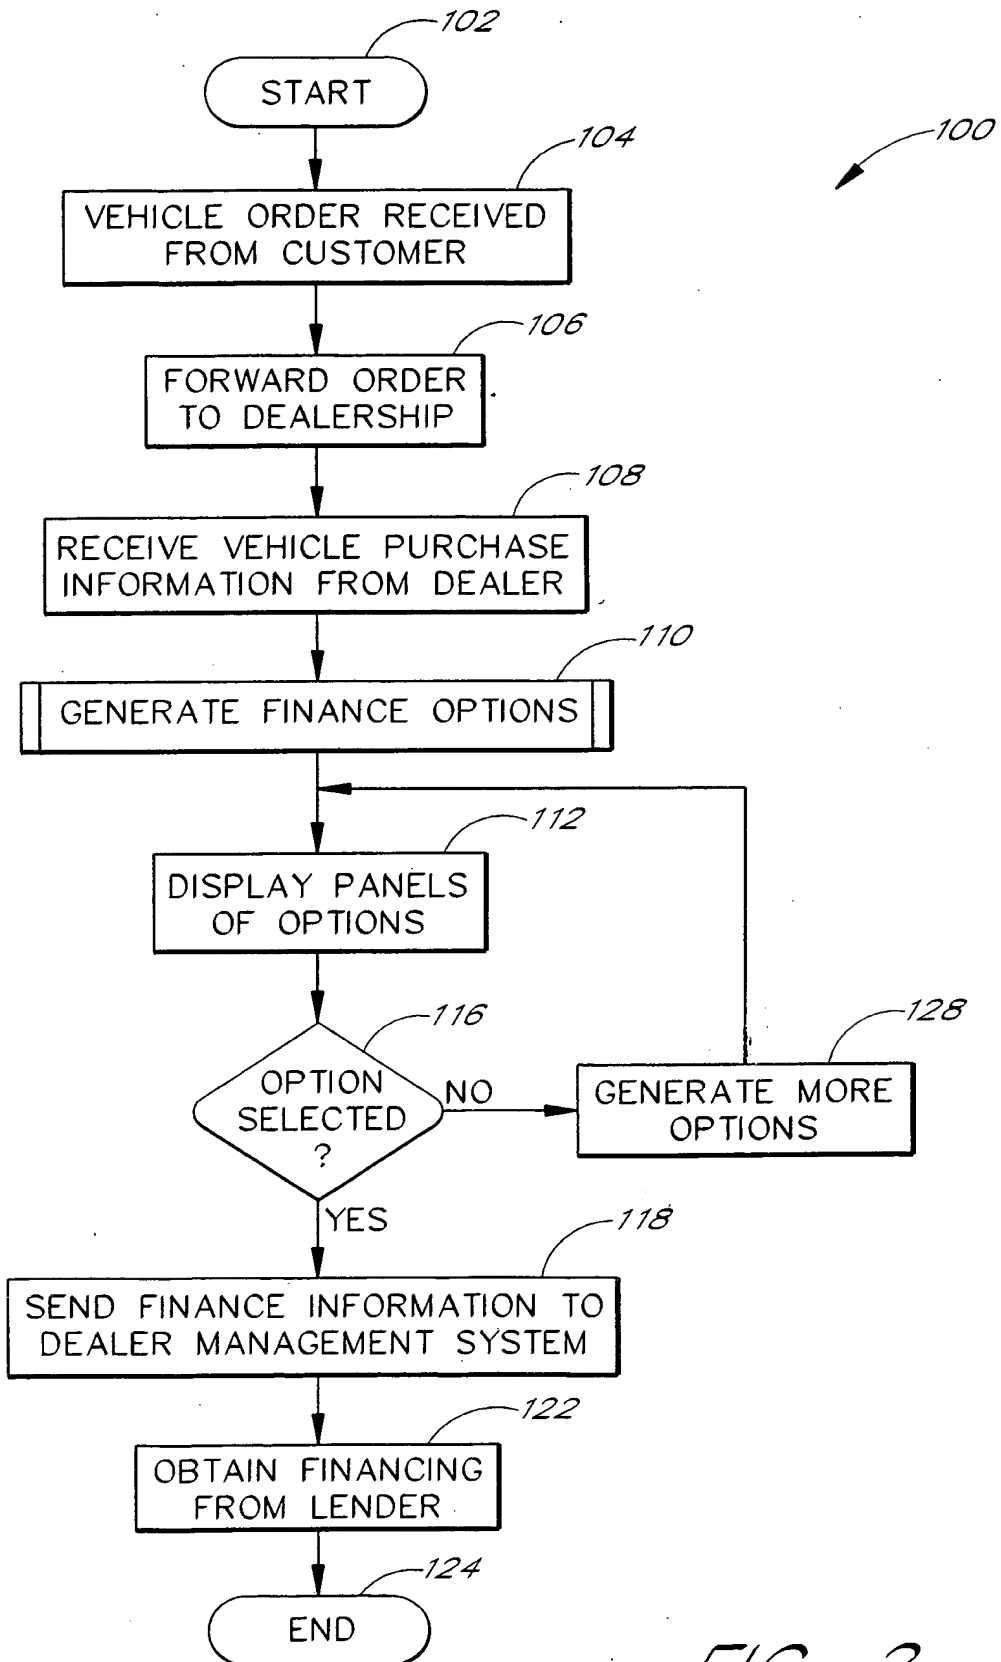


FIG. 1

RECEIVED
 NOV 15 2004
GROUP 3600




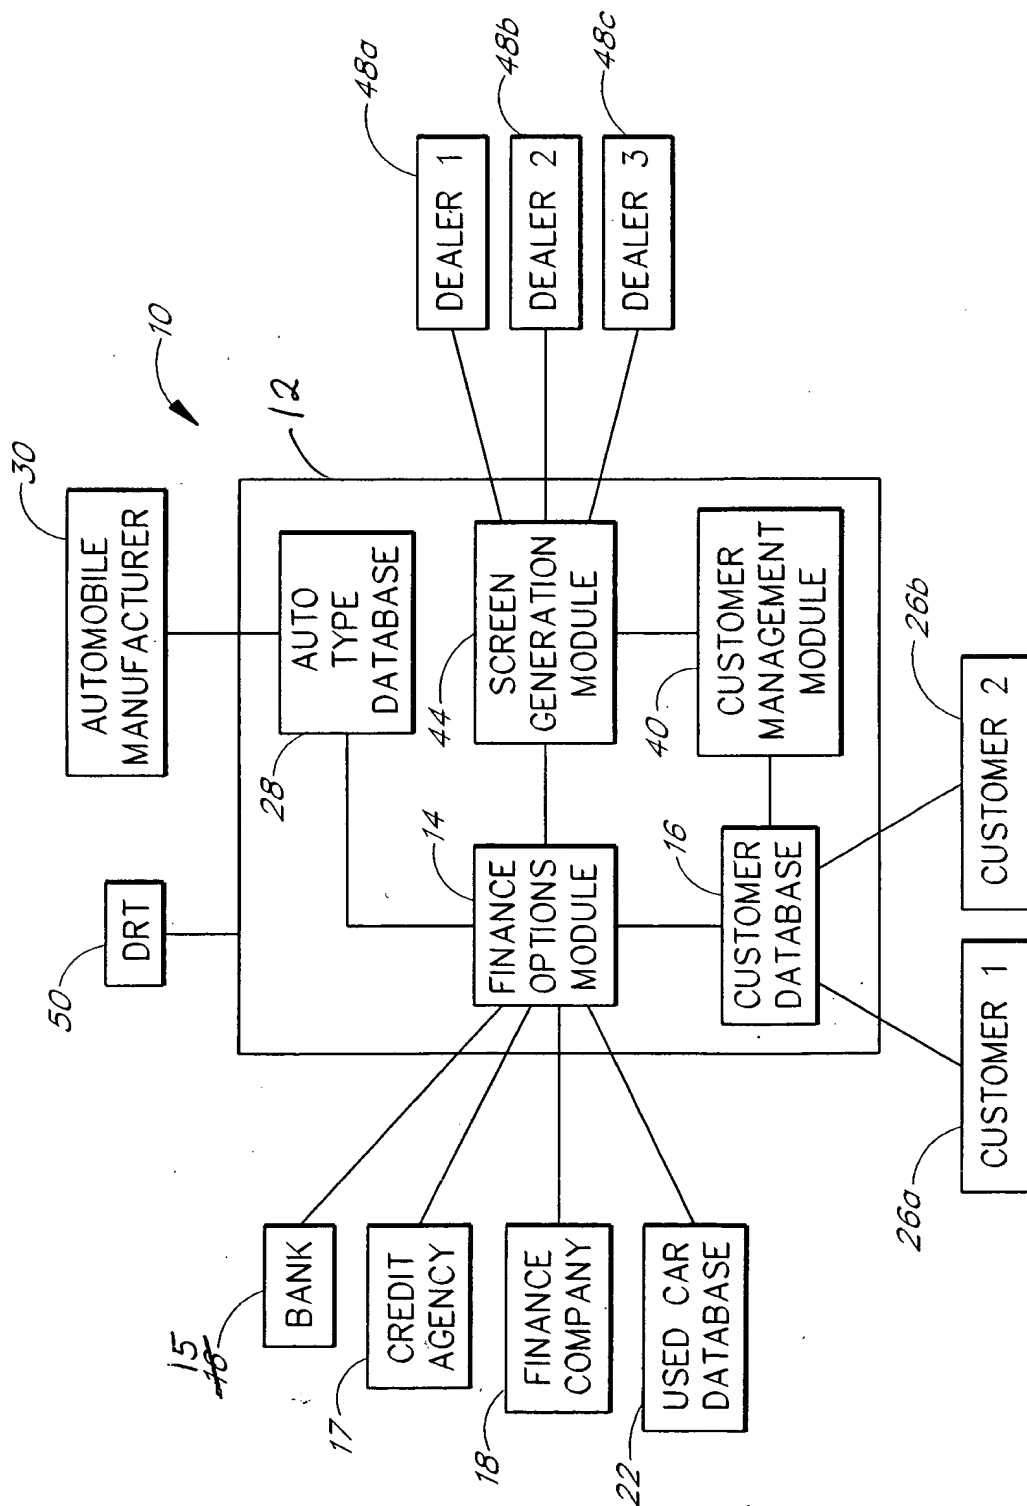


FIG. 1

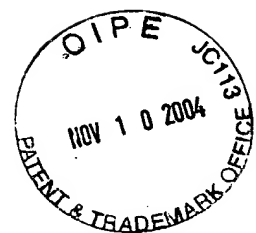

Red-Lined Drawing
ELECTRONIC FINANCING SYSTEM

Timothy Walker

Application No.: 09/737,168 • Atty. Docket: AUTOB.102A

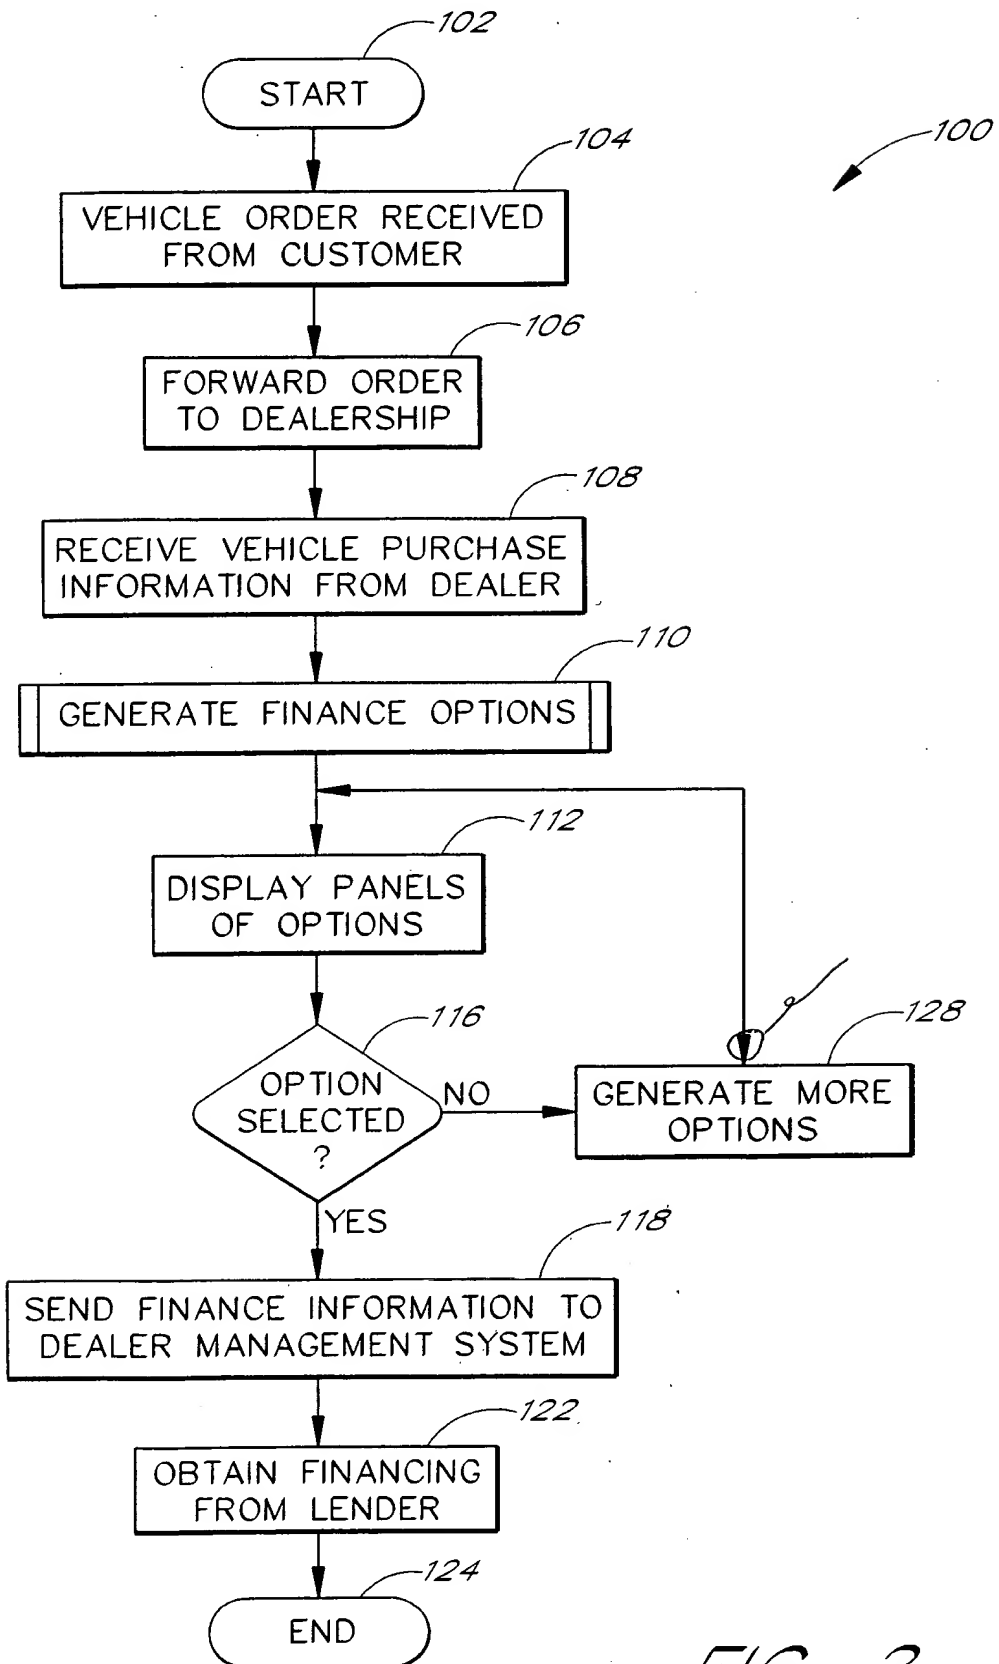


FIG. 2